




Prior Approval not required for demolition
Ref: 20/1188/DEM

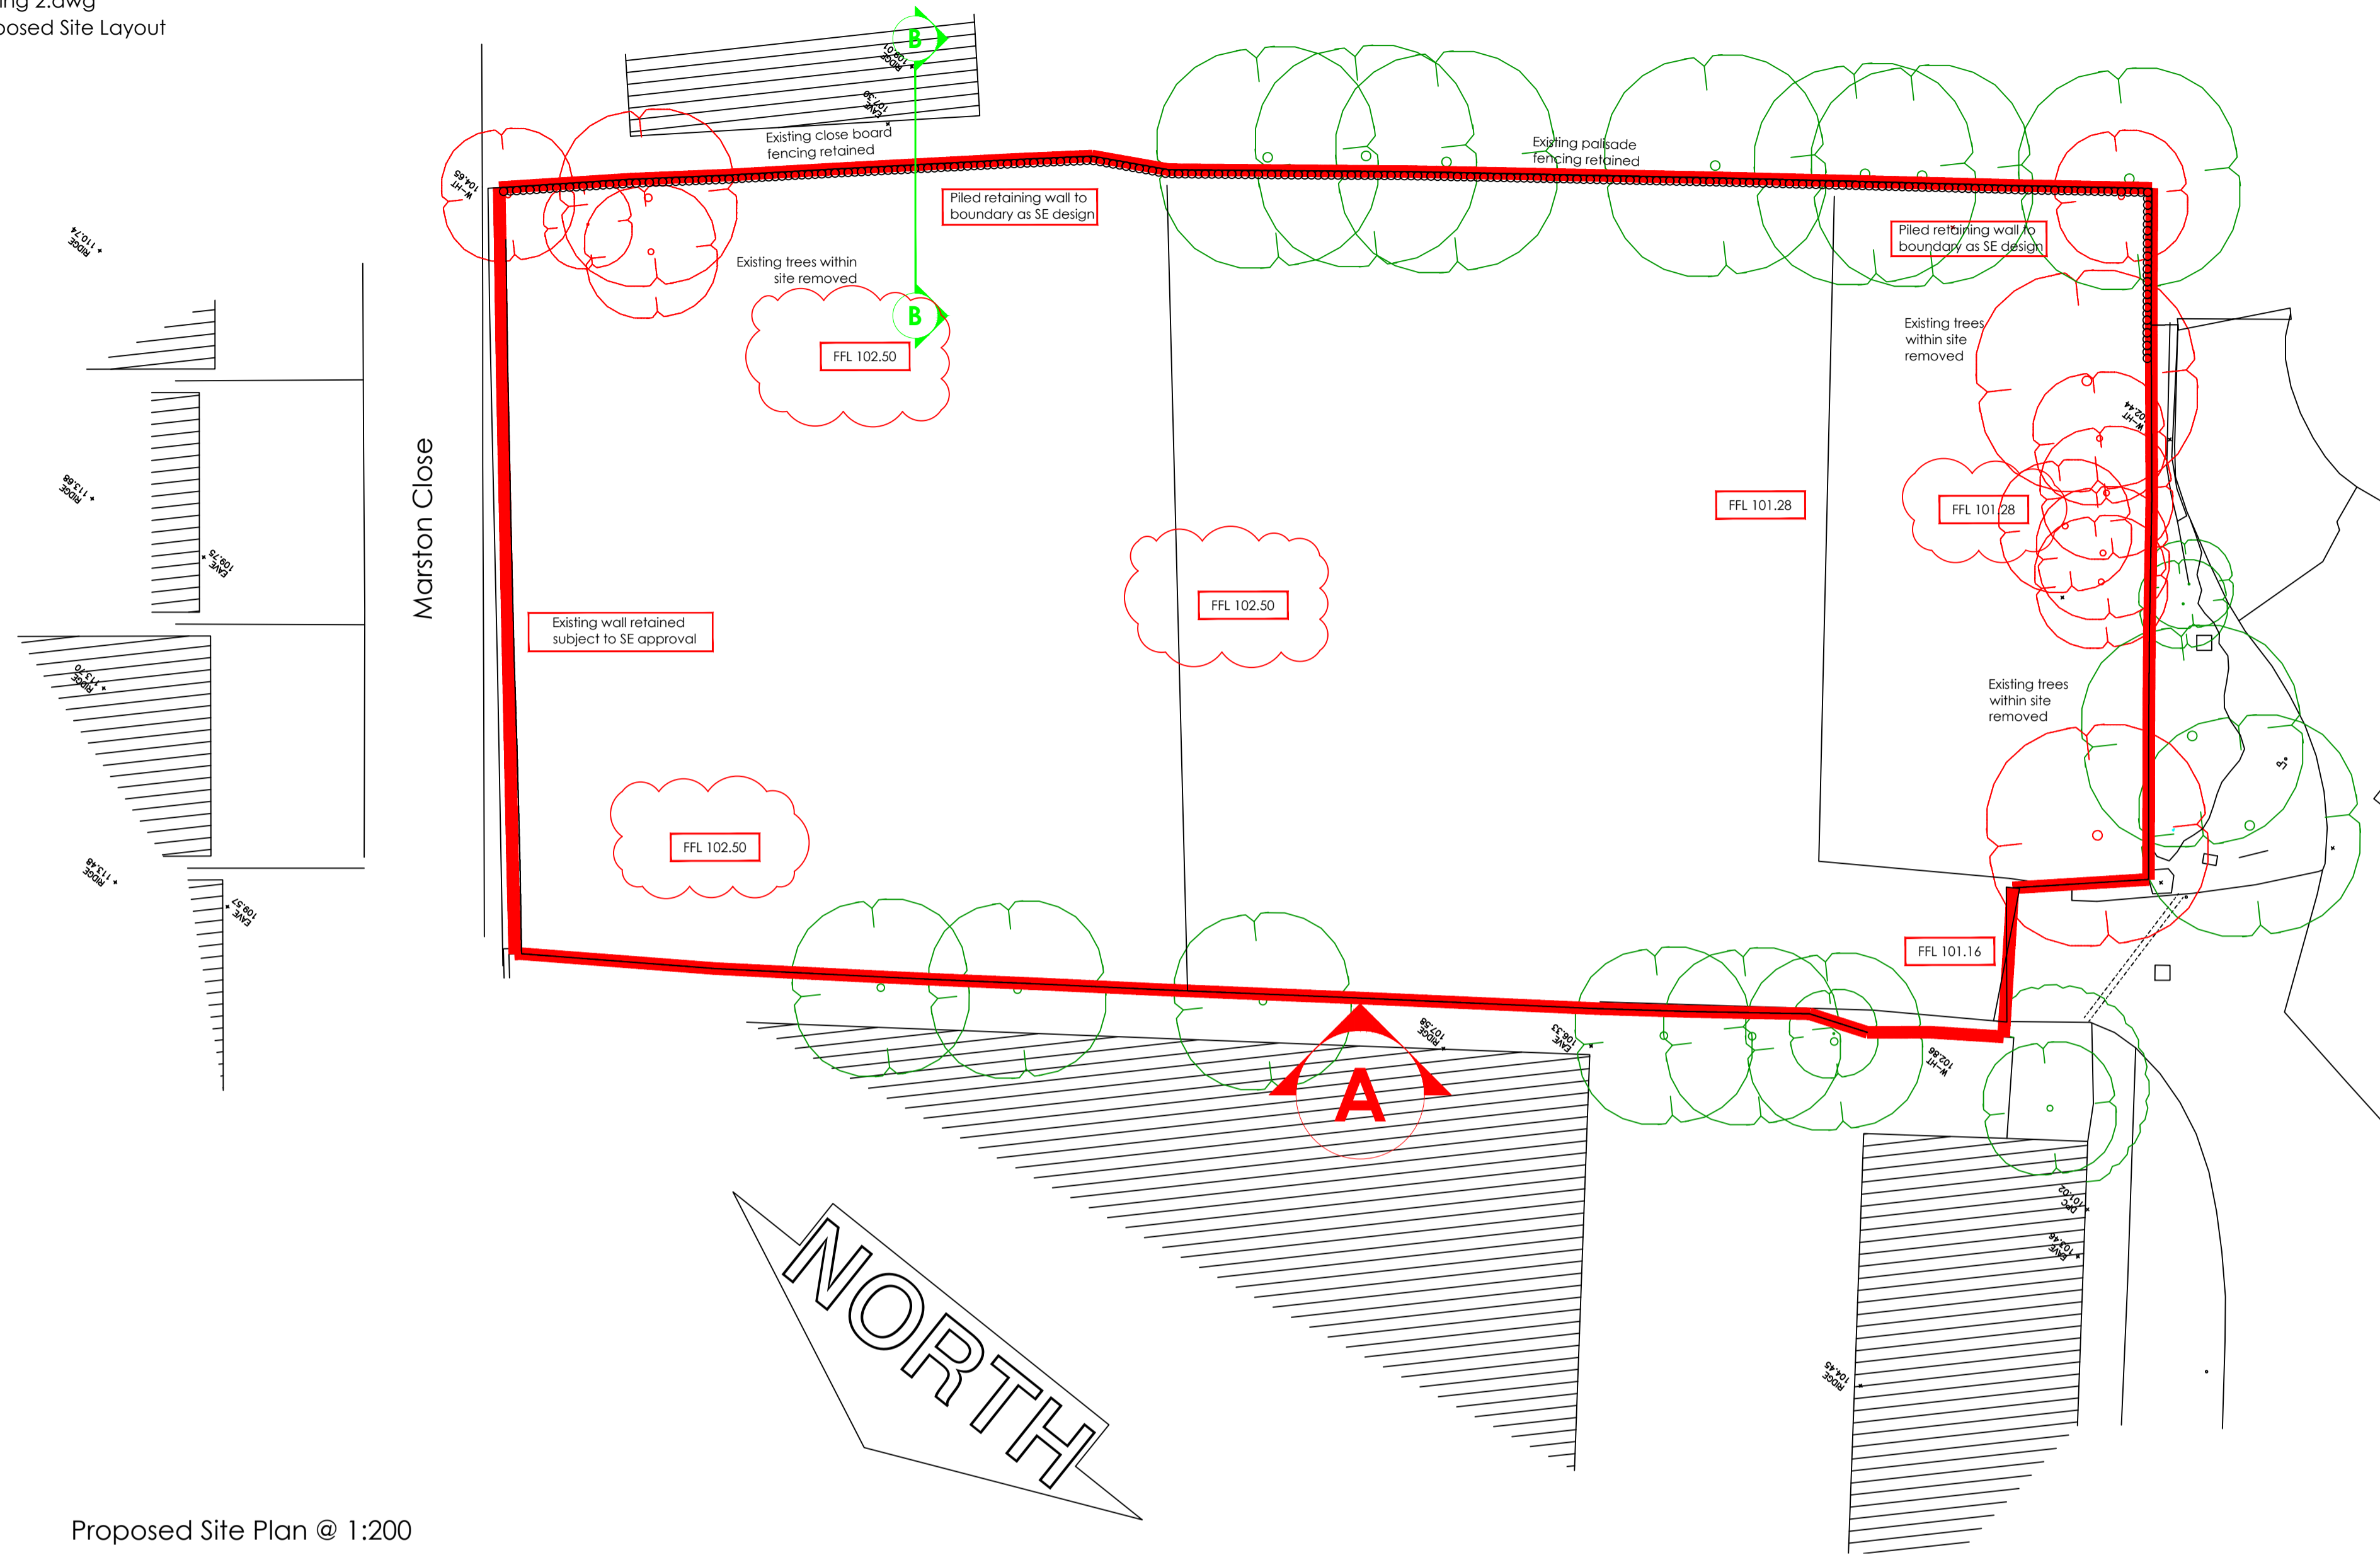

Proposed Site Plan @ 1:200

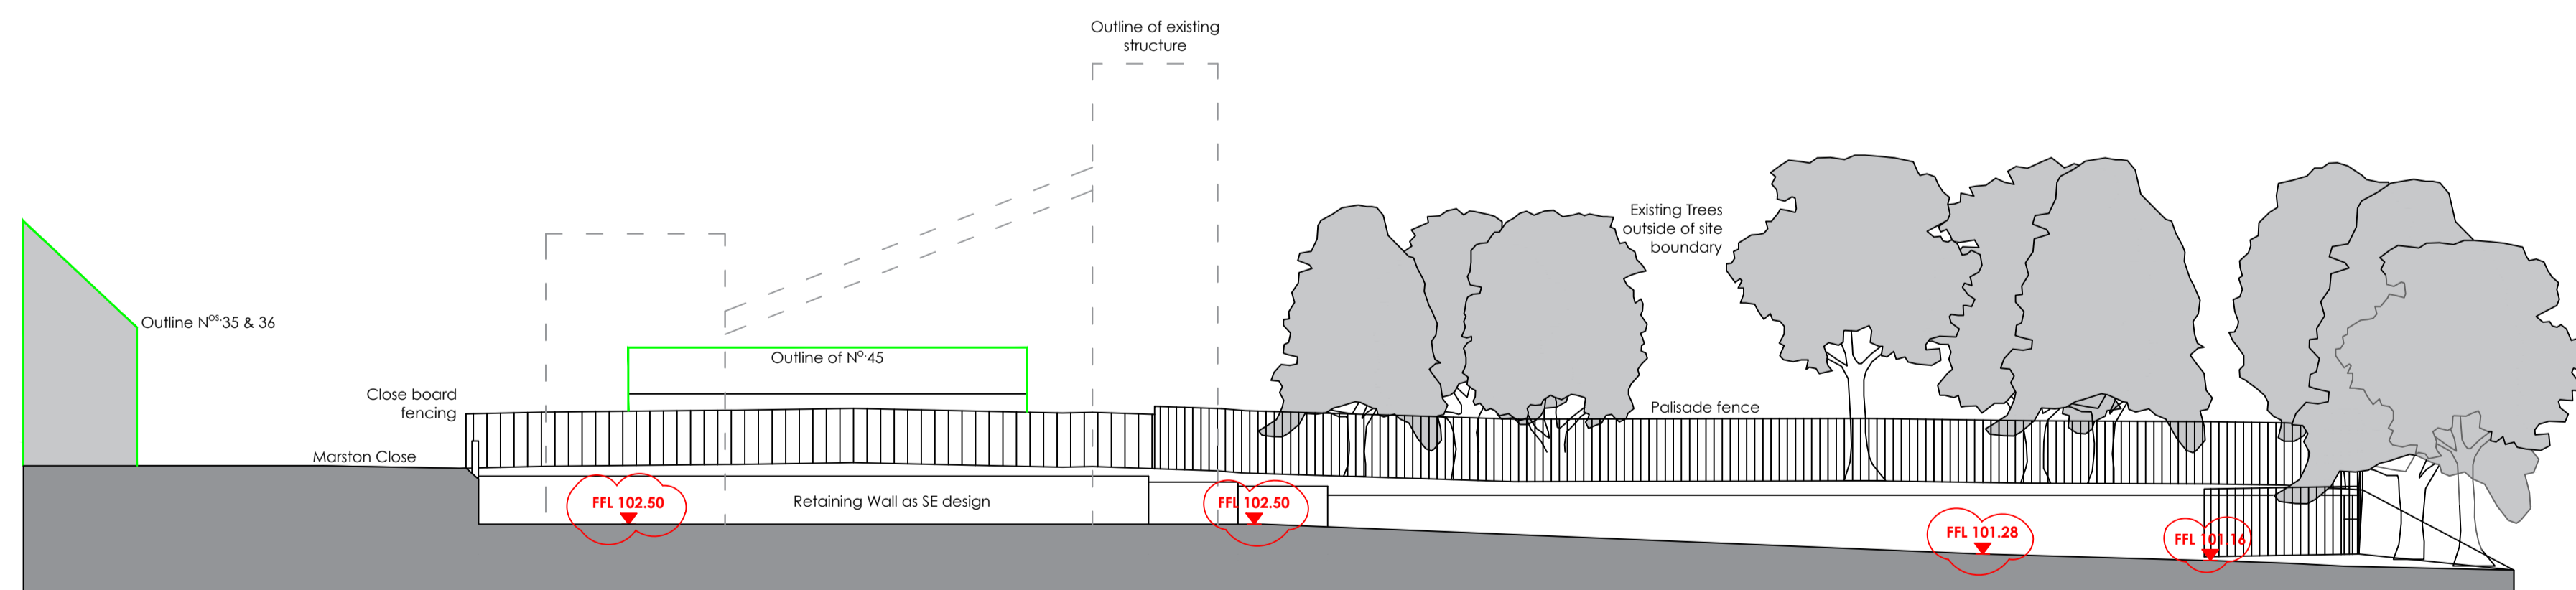

Proposed Site Elevation (A) @ 1:200

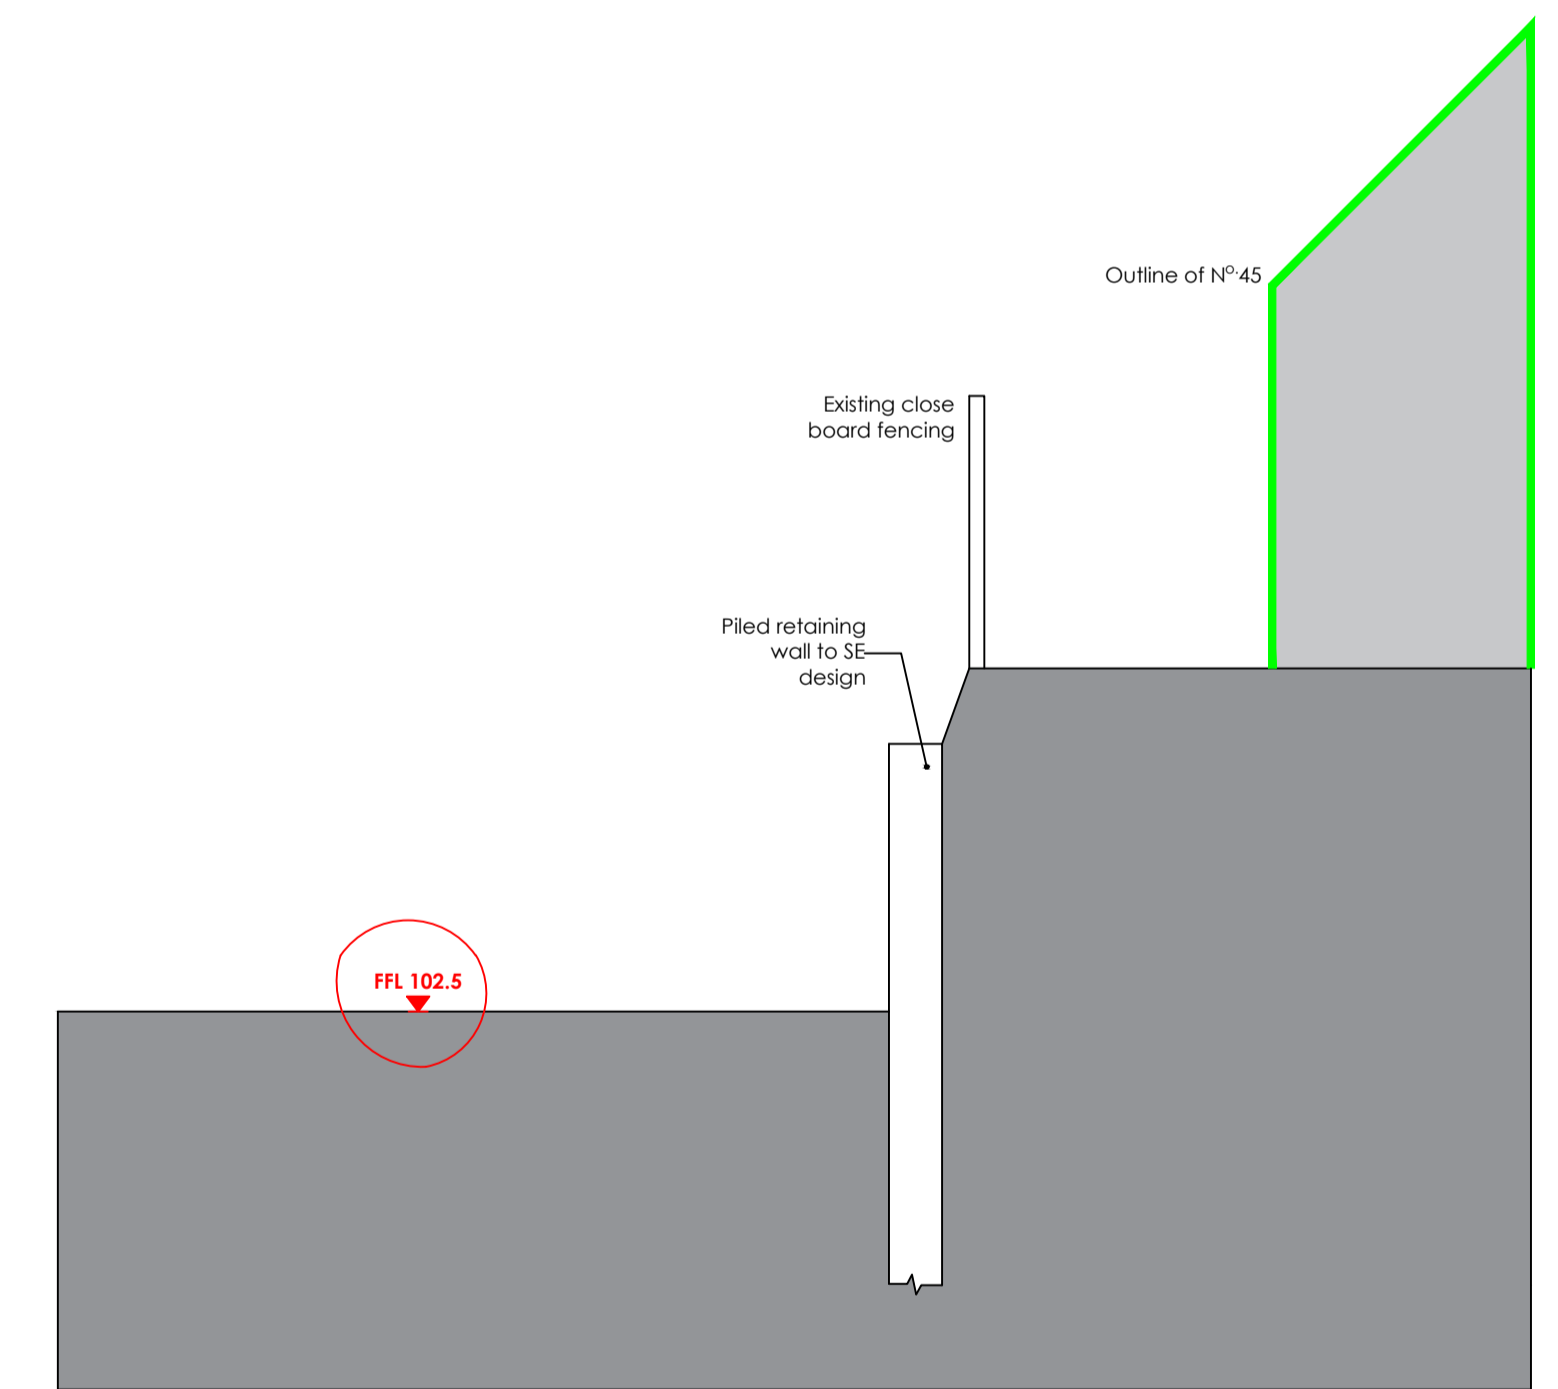

Proposed Section B-B @ 1:50

Rev B:-/MJB/18.01.21/Site levels updated
Rev A:-/MJB/18.12.20/Demolition reference added

Copyright of this drawing is retained by Masefields Marchant Brabbs Limited, not to be reproduced or copied without written consent.

Figured dimensions only to be taken from this drawing. It is the contractors responsibility to check all dimensions. Any boundaries indicated are those apparent from site survey. They may not be the legal boundaries. These must be verified by the site owner.

DRAWING STAGE

F= Feasibility
P= Planning stages
BR= Building Regulations
W= Working Drawings
AB= As built

P

CLIENT:
ERD Ltd

PROJECT:
New Commercial Units
Former Concrete Yard
Enfield Industrial Estate

TITLE:

Proposed Site Plan & Elevation

masefields
architects ■ surveyors

IN ASSOCIATION WITH:

Alan Smith Consultancy
■ ARCHITECTURE · PLANNING · DESIGN ■

Doric House, Church Street
Studley Warwickshire B80 7LG
Tel: 01527 910 190
Email: architecture@masefields.co.uk

| | | | |
|--------------------|------------------------|----------------|----------|
| Drawn A.N.OTHER | Ratio As Stated @A1 | Checked SAM | |
| Date Sep 20 | Job No 3620 | Drg No 011 | Rev B |