



PROPOSED
WALLS RENDERAILED FINISH (WHITE)
DOORS TO MATCH EXISTING. FINISHED.

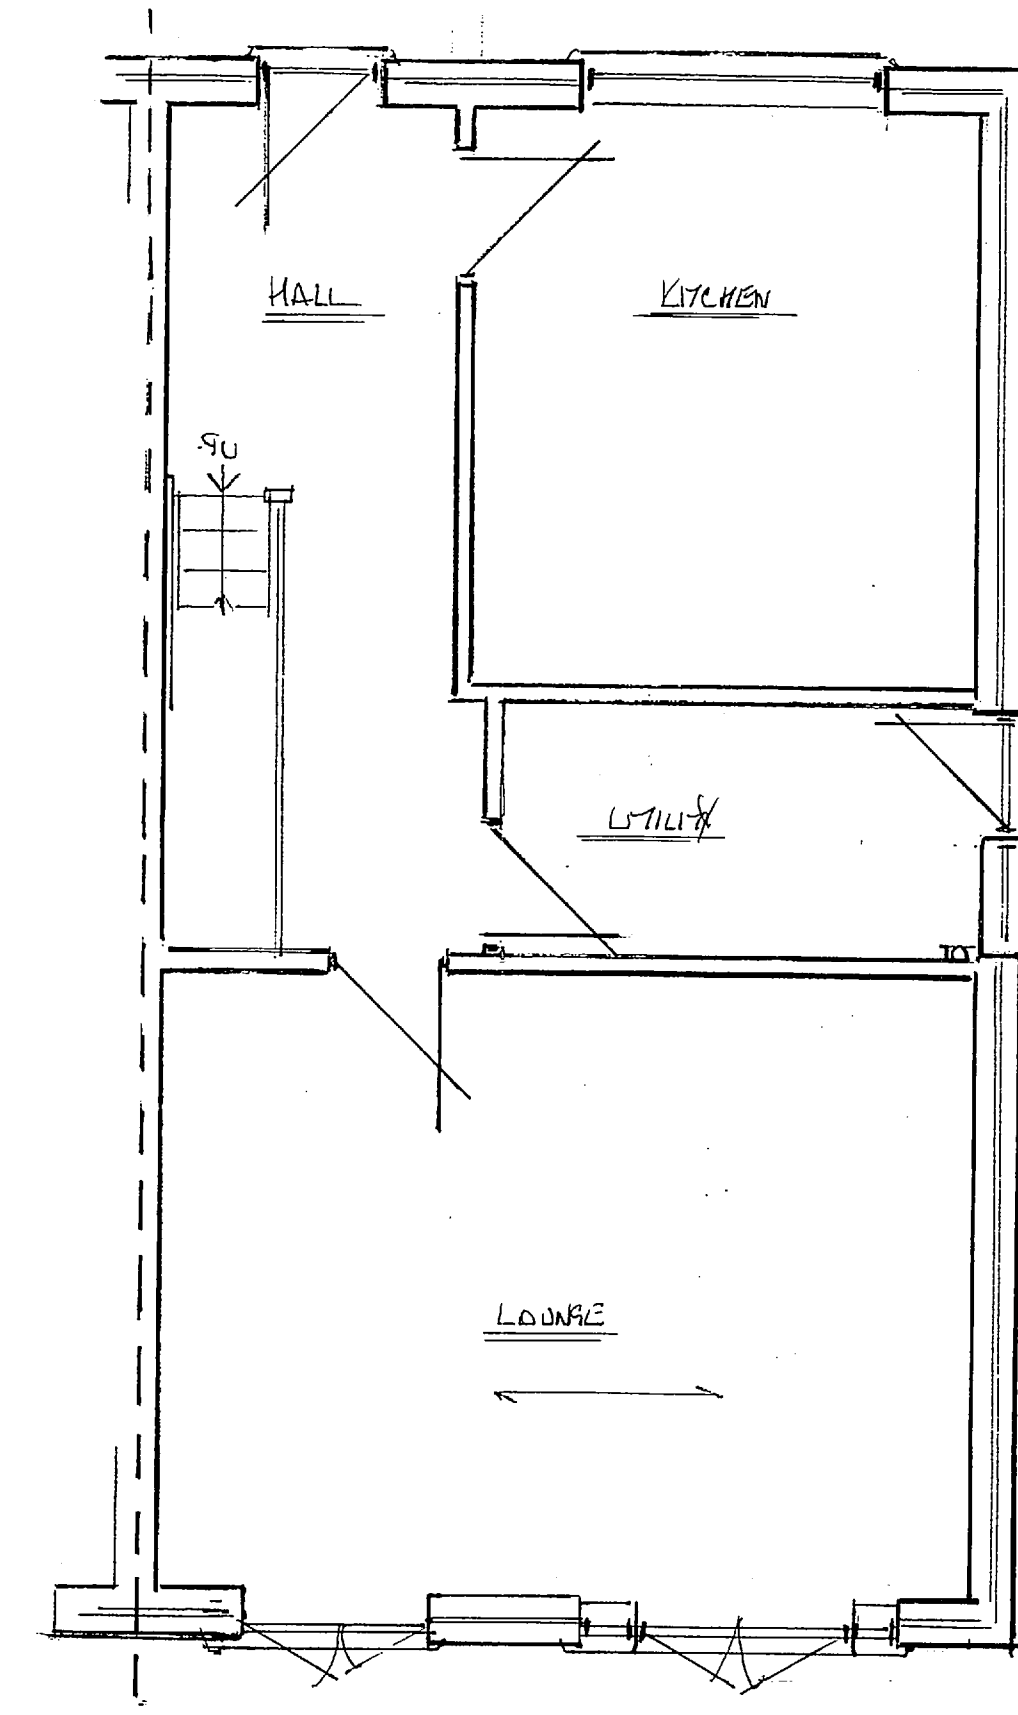

EXS GROUND FLOOR PLAN

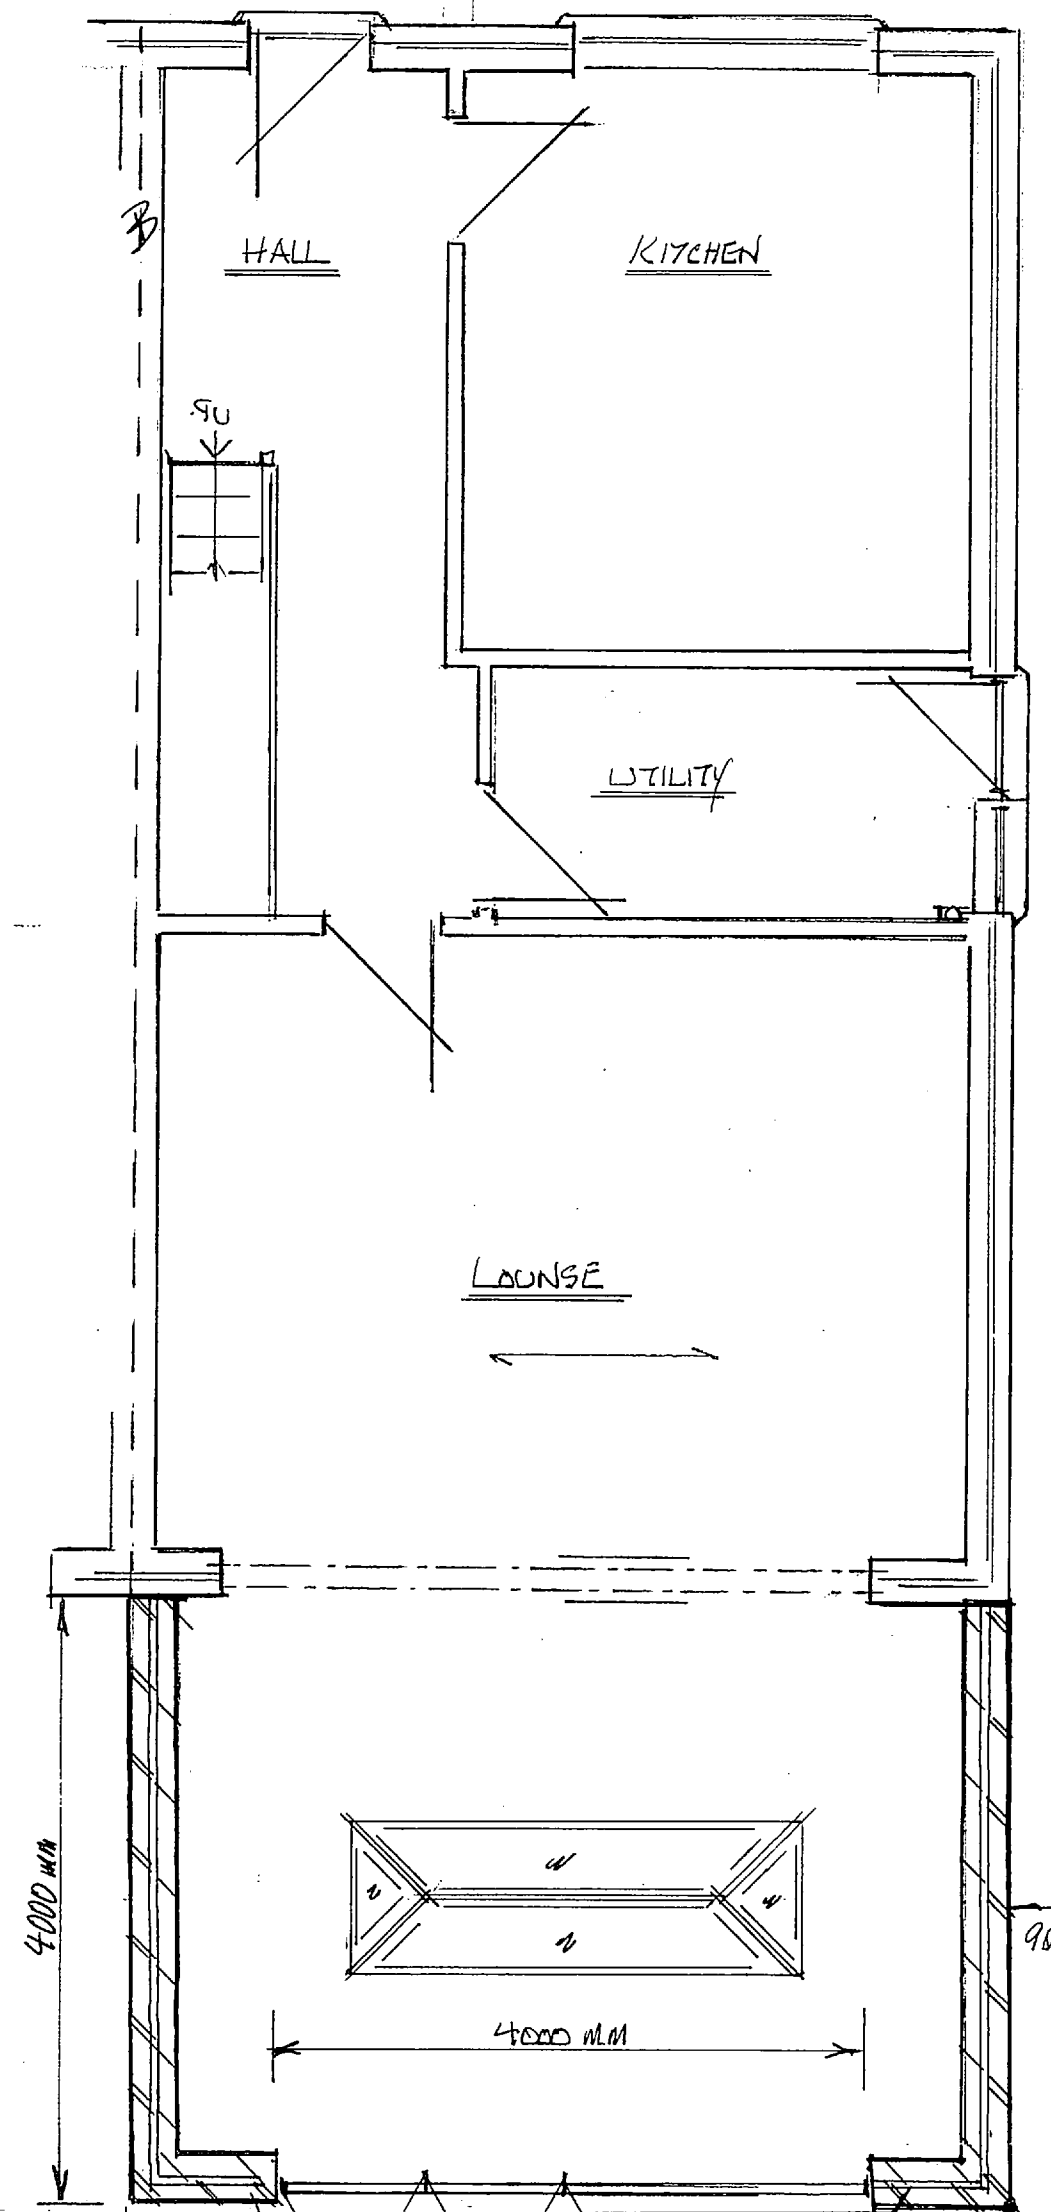

PROPOSED (AS BUILT) GROUND FLOOR PLAN

RETROSPECTIVE PLANNING APPLICATION:
R. M. Design 0121 742 4025
 PROPOSAL: SINGLE STOREY REAR EXTENSION.
 CLIENT: MR. DANIEL HUDSON
 LOCATION: 14, HOLLYWOOD DRIVE, B47, SPS
 DRAWN: R. MOLLOY. DATE: APRIL 2021
 SCALE: 1:50 - 1:100 @ A1 - DIMENSIONS 21/19.