




Notes:
Do not rely solely on drawing dimensions.

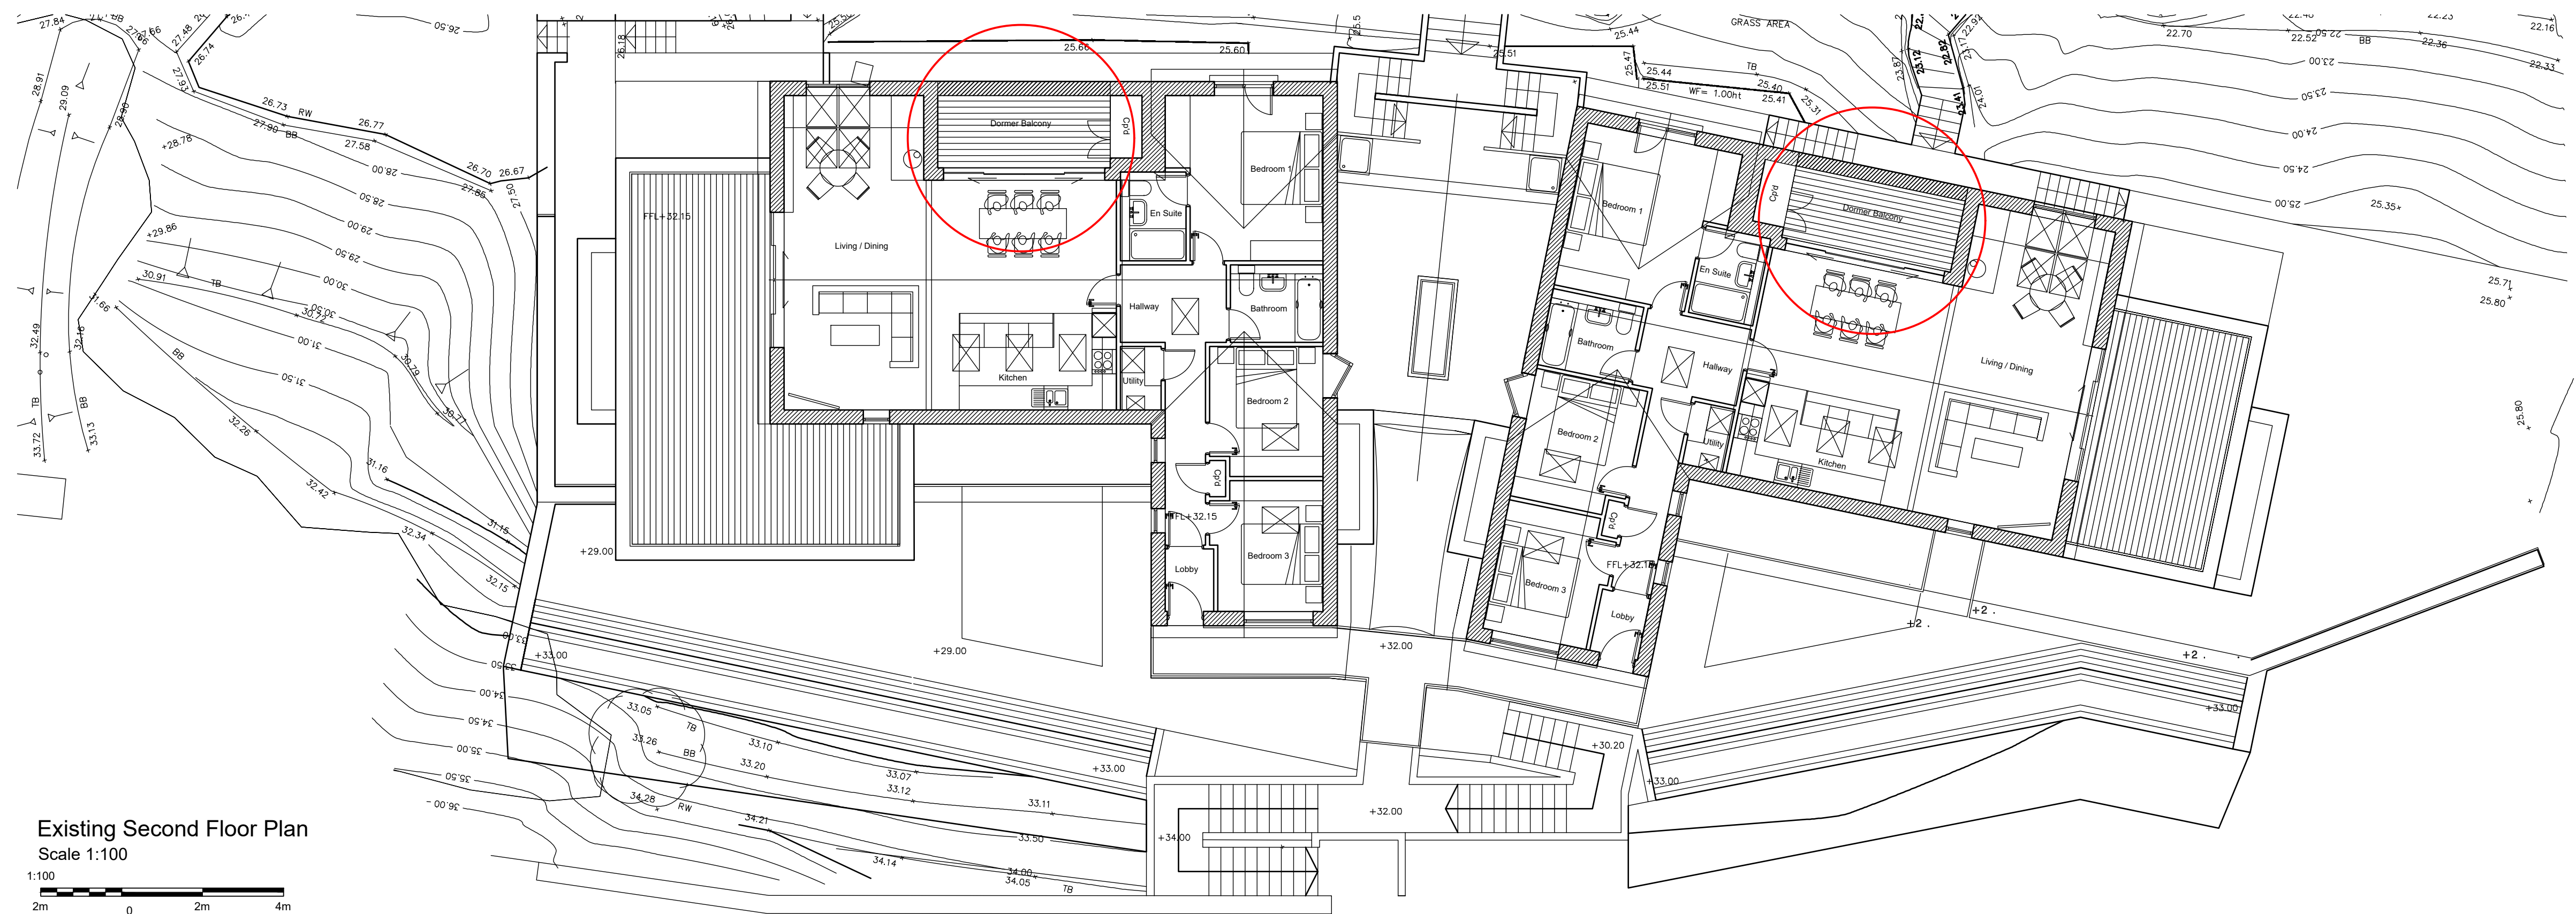

Existing Second Floor Plan
Scale 1:100

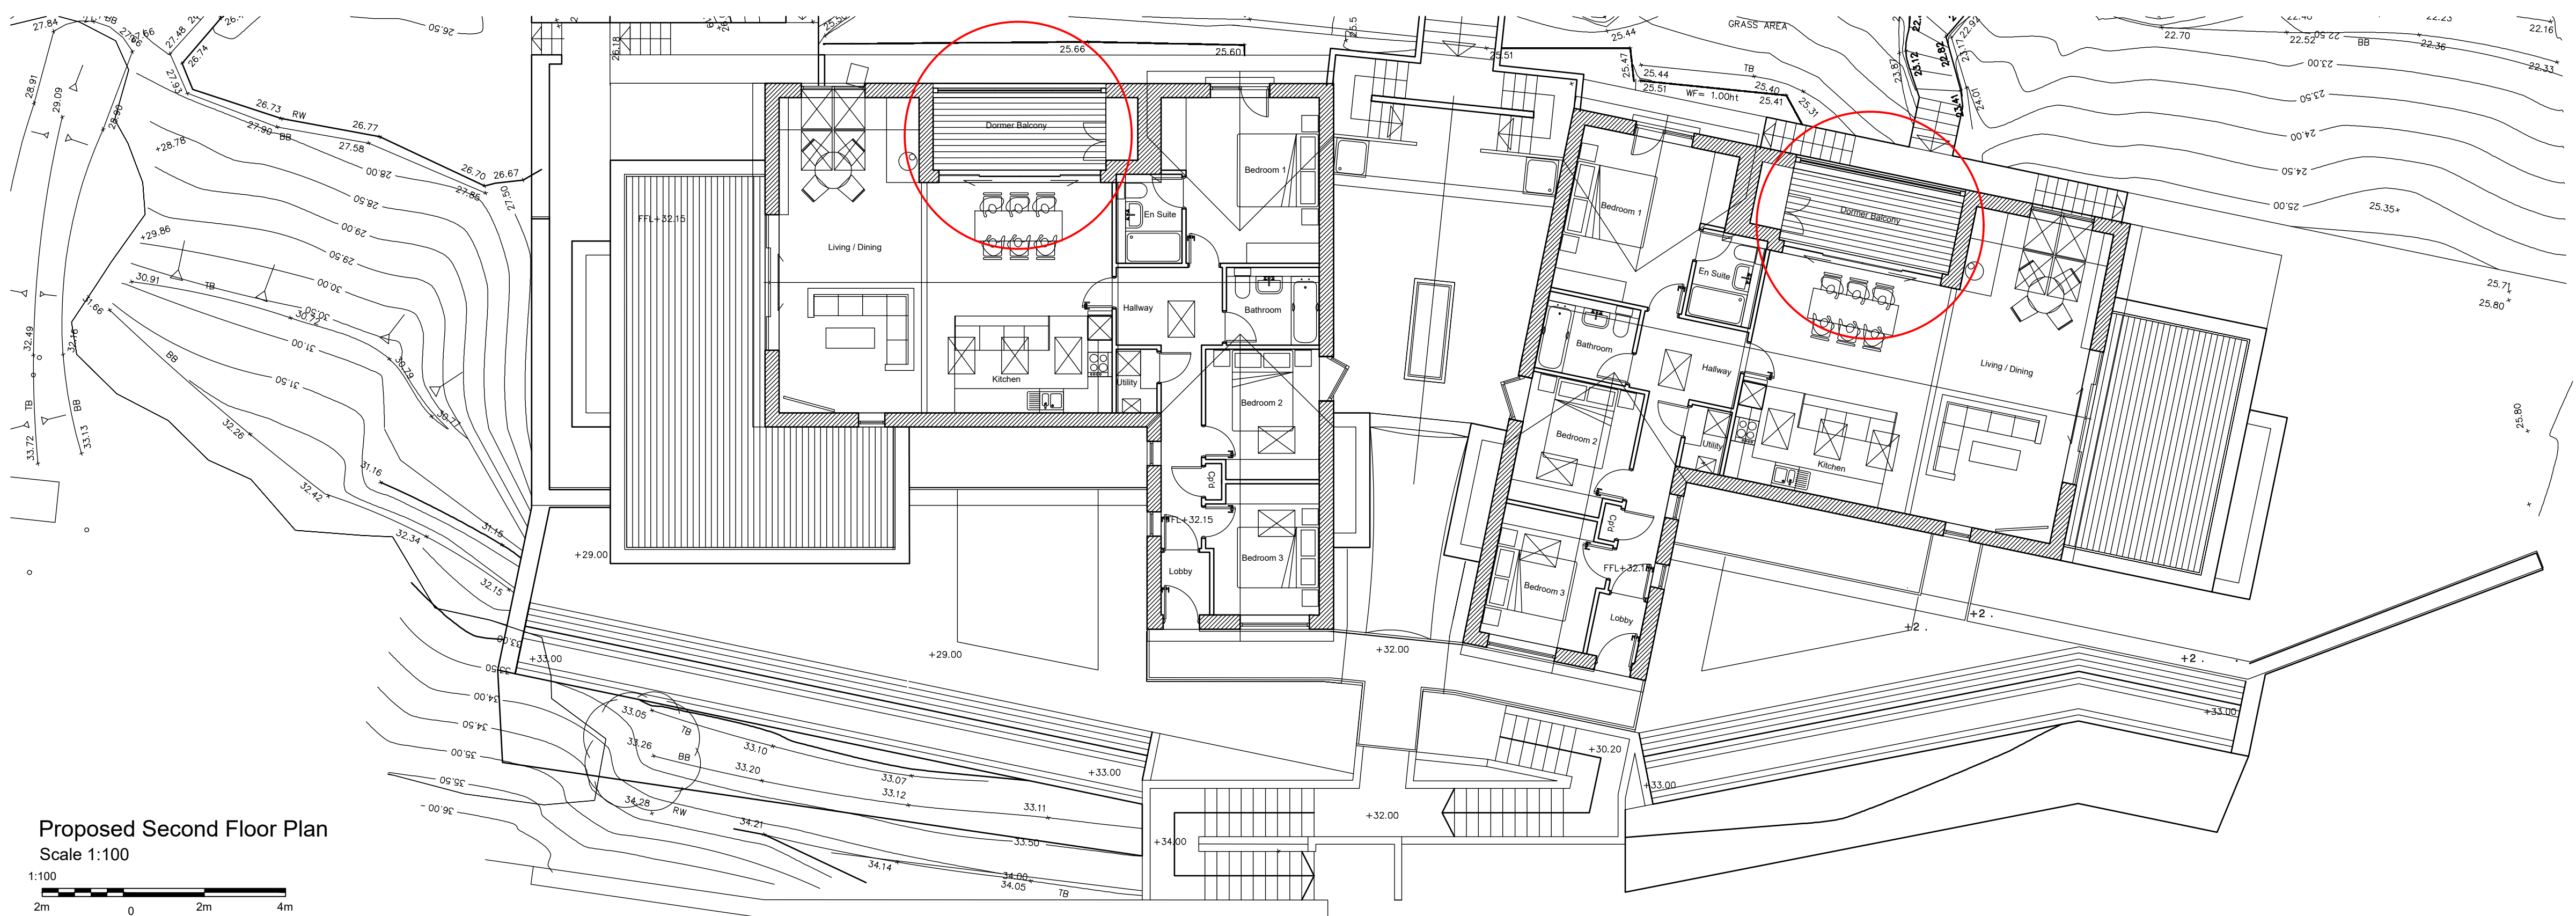

Proposed Second Floor Plan
Scale 1:100

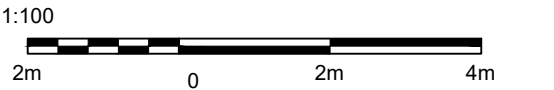

REVISION	AMENDMENT	INITIAL	DATE

- STATUS
- Sketch Scheme
 - Planning
 - Building Regulations
 - Tender
 - Contract
 - As Built

PROJECT
**The Beach Porthtowan
West Cliff
Porthtowan
TR4 8AE**

CLIENT
**The Beach Porthtowan
Management Co Ltd**

DRAWING TITLE
**Existing & Proposed
Second Floor Plans**

RTP
CHARTERED BUILDING SURVEYORS
RTP Surveyors
9 Mount Folly Square
Bodmin, Cornwall, PL31 2DF
T 01208 892020
F 01208 269476
E Bodmin@rtpsurveyors.co.uk
www.rtpsurveyors.co.uk
Office also at Falmouth

SCALE	DRAWN BY	DRAWING NO.	REV.	SIZE
Noted	AY	210530-202	0	A1
DATE:	CHECKED BY:			
16.08.21	RTP			

This drawing is copyright. All materials and workmanship to comply with the current British Standards and codes of practice. Contractors to check ALL dimensions. Work from figured dimensions ONLY. Report ANY discrepancy to Architect or Surveyor before proceeding. IF IN ANY DOUBT ASK.